

Work Order ID 149304

Friday, July 22, 2016 10:37:43 AM

149304

Page 1

Item ID: 646.3301

Accept

N900040100Setup Start ***NS1***

Revision ID:

Stop ***NS2***

Item Name: Upper Cutter Assy

Start Date: 7/22/2016 Start Qty: 5.00

5

Cust Item ID:

Required Date: 8/18/2016 Req'd Qty: 5.00

5

Customer:

Reference:

Approvals:

Process Plan: emDate: 16/01/22

Tooling:

Date:

Run Start ***NR1***

QC:

Date:

SPC (Y/N):

Date:

Stop ***NR2***

Sequence ID/ Work Center ID	Operation Description	Set Up/ Run Hours	Tool ID	Tool #	Plan Code	Accept Qty	Reject Qty	Reject Number	Insp. Stamp
--------------------------------	--------------------------	----------------------	---------	--------	--------------	---------------	---------------	------------------	----------------

Draw Nbr	Revision Nbr
646.3300	NC3

110	Pick Kit	0.00
-----	----------	------

110

Packaging

Memo

0.07

Packaging

S DAS 6 8-89 JUL 27 2016

120

0.00

120

Small Fab

Memo

0.50

Small Fab

TWO fastener must be install finger-tight (see note 9)

Assemble as per dwg and apply loctite 598 on all faying surfaces shown on dwg per note 7.

A/R RTV LOCTITE 598:

exp. date: 04/181135497

SX 16/11/02 DAS 36 9-89

DQA:

Date:

DEC - 8 2016

JAN 3 2017



QA Closed:

Date:

DEC - 8 2016

WORK ORDER NON-CONFORMANCE / UPDATE

Work Order update only ☐

Work Order: <u>149304</u>		DISPOSITION		AGAINST DEPARTMENT/PROCESS					
Part No. <u>646 3301</u>		Rework ☒		Skid-tube ☐	Cross tube ☐	Water Jet ☐	Engineering ☐		
NCR No. <u>16-6114</u>		Scrap ☐		Machining ☐	Small Fab ☐	Prod. Eng. Coord. ☐	Quality ☐		
		Use-as-is ☐		Thermoforming ☐	Finishing ☒	Rec/Store/Packaging ☐	Other ☐		
		Suspected Unapproved ☐		Large Fab ☐	Composite ☐	Supplier ☐			
Date: <u>16-10-27</u>		Step #: <u>110</u>		QTY Effective: <u>①</u>			MRB (QSI042) Approval		
Description Work Order Deviation		Disposition			Completed By				
Found a assembly qty 1 of 646.3311 B142624 was missing some primer R.C. supplier		apply light coat of primer B#134100			DAS 9 9-89 16-10-27				
					Lead hand / Supervisor Approval Verification DAS 9 9-89 16-10-31				
					QC / QA Coordinator Approval DAS 9 9-89 16-10-31				
Root Cause		FAULT CATEGORY							
Environment ☐	No Re-verification ☐	Pressure/Forced ☐	Temperature/Cure ☐	Power Loss/Surge ☐	Positioned Wrong ☐				
Design ☐	Operator ☐	Bending ☐	Set-up ☐	Folio/Program ☐	Outside Dimensions ☐				
Doc/Data ☐	Offset/Setup ☐	Centre Not Concentric ☐	BOM/Route ☐	Grain ☐	Over/Under tolerance ☐				
Equip/Tooling ☐	Supplier ☒	Cracks ☐	Broken/Damage/Defect ☐	Weld ☐	Part Incorrect ☐				
Handling/Pre ☐	Training ☐	Crimp/Kink/Ripple/Wave ☐	Inspection Incomplete/Unqualified ☐	Wrong Stock Pulled ☐	Part Lost/Missing ☐				
Material ☐	Use for Testing ☐	Cuffs ☐	Contamination ☐	Out of Sequence ☐	Part Moved ☐				
Internal Transport ☐	Poor Information ☐	Crushing ☐	Countersink ☐	Off-set ☐	Drawing ☐				
Tribal Knowledge ☐	Rushing ☐	Heat Treat ☐	Cut Too Short ☐	Mislabeled ☐	Finish ☒				
LOA ☐	Product Improvement ☐	Wave/Twist in Tube ☐	Instructions Incomplete/Unclear ☐	Fit/Function ☐	Misread ☐				
Substation ☐	Process Improvement ☐	Marks/Chatter ☐	Drill Holes ☐	Misaligned/off center ☐	Turning Sequence ☐				
Past Expiry Date ☐	Manufacturing Process ☐								
Misidentified ☐	Past Due ☐	OTHER :							

Work Order ID 149304

Friday, July 22, 2016 10:37:43 AM

149304

Page 2

Item ID: 646.3301

Accept

N900040100

Setup Start

NS1

Revision ID:

Stop

NS2

Item Name: Upper Cutter Assy

Start Date: 7/22/2016 Start Qty: 5.00

5

Cust Item ID:

Required Date: 8/18/2016 Req'd Qty: 5.00

5

Customer:

Reference:

Approvals:

Process Plan:

Date:

Tooling:

Date:

Run Start

NR1

QC:

Date:

SPC (Y/N):

Date:

Stop

NR2Sequence ID/
Work Center IDOperation
DescriptionSet Up/
Run Hours

Tool ID

Tool # Plan
CodeAccept
QtyReject
QtyReject
NumberInsp.
Stamp

130

QC5- Inspect part completeness to step on W/O

0.00

130

QC

Memo

0.07

Quality Control

DAS
38
NOV 02 2016

140

Identify as per dwg & Stock Location: CCK016 0.00***140***

Packaging

Memo

0.02

Packaging

***IDENTIFY AS PER APICAL MPP-120 BY STAMPING THE P# AND
REV***

5

DAS
6
9-89

NOV 03 2016

150

QC21- Final Inspection - Work Order Release

0.00

150

QC

Memo

0.01

Quality Control

DAS
21
9-89

NOV 04 2016

16-11-03

DQA: _____ Date: _____



WORK ORDER NON-CONFORMANCE / UPDATE

QA Closed: _____ Date: _____

Work Order update only ☐

Work Order: _____ Part No. _____ NCR No. _____		DISPOSITION Rework ☐ Scrap ☐ Use-as-is ☐ Suspected Unapproved ☐		AGAINST DEPARTMENT/PROCESS Skid-tube ☐ Machining ☐ Thermoforming ☐ Large Fab ☐ Cross tube ☐ Small Fab ☐ Finishing ☐ Composite ☐ Water Jet ☐ Prod. Eng. Coord. ☐ Rec/Store/Packaging ☐ Supplier ☐ Engineering ☐ Quality ☐ Other ☐	
Date :		Step #:		QTY Effective :			MRB (QSI042) Approval	
Description Work Order Deviation				Disposition				Completed By Lead hand / Supervisor Approval Verification QC / QA Coordinator Approval	
Root Cause		FAULT CATEGORY	
Environment ☐	No Re-verification ☐	Pressure/Forced ☐	Temperature/Cure ☐	Power Loss/Surge ☐	Positioned Wrong ☐	Design ☐	Operator ☐	Bending ☐	Set-up ☐	Folio/Program ☐	Outside Dimensions ☐	Doc/Data ☐	Offset/Setup ☐	Centre Not Concentric ☐	BOM/Route ☐	Grain ☐	Over/Under tolerance ☐	Equip/Tooling ☐	Supplier ☐	Cracks ☐	Broken/Damage/Defect ☐	Weld ☐	Part Incorrect ☐	Handling/Pre ☐	Training ☐	Crimp/Kink/Ripple/Wave ☐	Inspection Incomplete/Unqualified ☐	Wrong Stock Pulled ☐	Part Lost/Missing ☐	Material ☐	Use for Testing ☐	Cuffs ☐	Contamination ☐	Out of Sequence ☐	Part Moved ☐	Internal Transport ☐	Poor Information ☐	Crushing ☐	Countersink ☐	Off-set ☐	Drawing ☐	Tribal Knowledge ☐	Rushing ☐	Heat Treat ☐	Cut Too Short ☐	Mislabeled ☐	Finish ☐	LOA ☐	Product Improvement ☐	Wave/Twist in Tube ☐	Instructions Incomplete/Unclear ☐	Fit/Function ☐	Misread ☐	Substation ☐	Process Improvement ☐	Marks/Chatter ☐	Drill Holes ☐	Misaligned/off center ☐	Turning Sequence ☐	Past Expiry Date ☐	Manufacturing Process ☐	OTHER : _____	
Misidentified ☐	Past Due ☐	

Picklist Print

Friday, July 22, 2016 10:37:42 AM

Page 1

Work Order ID: 149304

149304

Parent Item: 646.3301

646.3301

Parent Item Name: Upper Cutter Assy

Start Date: 7/22/2016

Required Date: 8/18/2016

Start Qty: 5.00

Required Qty: 5.00

Comments: IPP REV:A 12.10.19 NEW ISSUE DD VERF:JLM
REV:B 15.01.07 AS PER DWG NC3 DD VERF:JLM

IPP

Component Item ID/ Item Name	Replacement Item ID	Mfg/ Purch	Bin Item	Primary Location	Last Location	Route Seq ID	Unit of Measure	Qty on Hand	Qty per Kit	Total Qty	Qty Issued	Date Issued	Status
646.3310		Manufactured	No			110	Each	6.0000	1	5			
646.3310									**				DAS 6 9-89
LH Half - Upper Cutter Assembly													
				<u>Location</u>				<u>Loc Qty</u>		<u>Loc Code</u>			
				CCK022				6					
				142474				6		5			
646.3311		Manufactured	No			110	Each	13.0000	1	5			
646.3311									**				DAS 6 9-89
RH Half - Upper Cutter Assembly													
				<u>Location</u>				<u>Loc Qty</u>		<u>Loc Code</u>			
				CCK022				13					
				141005				1		1			
				142624				12		4			
646.3312		Manufactured	No			110	Each	5.0000	1	5			
646.3312									**				DAS 6 9-89
Center Plate													
				<u>Location</u>				<u>Loc Qty</u>		<u>Loc Code</u>			
				cck103				5		5			
				142633				5		5			
646.3313		Manufactured	No			110	Each	17.0000	1	5			
646.3313									**				DAS 6 9-89
Upper Guide													
				<u>Location</u>				<u>Loc Qty</u>		<u>Loc Code</u>			
				cck059A				17		5			
				141020				17		5			

DQA: _____ Date: _____



WORK ORDER NON-CONFORMANCE / UPDATE

QA Closed: _____ Date: _____

Work Order update only ☐

Work Order: _____ Part No. _____ NCR No. _____		DISPOSITION Rework ☐ Scrap ☐ Use-as-is ☐ Suspected Unapproved ☐		AGAINST DEPARTMENT/PROCESS Skid-tube ☐ Machining ☐ Thermoforming ☐ Large Fab ☐ Cross tube ☐ Small Fab ☐ Finishing ☐ Composite ☐ Water Jet ☐ Prod. Eng. Coord. ☐ Rec/Store/Packaging ☐ Supplier ☐ Engineering ☐ Quality ☐ Other ☐					
Date :		Step #:		QTY Effective :			MRB (QSI042) Approval		
Description Work Order Deviation				Disposition				Completed By	
								Lead hand / Supervisor Approval Verification	
Root Cause		FAULT CATEGORY							
Environment ☐	No Re-verification ☐	Pressure/Forced ☐	Temperature/Cure ☐	Power Loss/Surge ☐	Positioned Wrong ☐				
Design ☐	Operator ☐	Bending ☐	Set-up ☐	Folio/Program ☐	Outside Dimensions ☐				
Doc/Data ☐	Offset/Setup ☐	Centre Not Concentric ☐	BOM/Route ☐	Grain ☐	Over/Under tolerance ☐				
Equip/Tooling ☐	Supplier ☐	Cracks ☐	Broken/Damage/Defect ☐	Weld ☐	Part Incorrect ☐				
Handling/Pre ☐	Training ☐	Crimp/Kink/Ripple/Wave ☐	Inspection Incomplete/Unqualified ☐	Wrong Stock Pulled ☐	Part Lost/Missing ☐				
Material ☐	Use for Testing ☐	Cuffs ☐	Contamination ☐	Out of Sequence ☐	Part Moved ☐				
Internal Transport ☐	Poor Information ☐	Crushing ☐	Countersink ☐	Off-set ☐	Drawing ☐				
Tribal Knowledge ☐	Rushing ☐	Heat Treat ☐	Cut Too Short ☐	Mislabeled ☐	Finish ☐				
LOA ☐	Product Improvement ☐	Wave/Twist in Tube ☐	Instructions Incomplete/Unclear ☐	Fit/Function ☐	Misread ☐				
Substation ☐	Process Improvement ☐	Marks/Chatter ☐	Drill Holes ☐	Misaligned/off center ☐	Turning Sequence ☐				
Past Expiry Date ☐	Manufacturing Process ☐	OTHER :							
Misidentified ☐	Past Due ☐								

Picklist Print

Friday, July 22, 2016 10:37:42 AM

Page 2

Work Order ID: 149304

149304

Parent Item: 646.3301

646 3301

Parent Item Name: Upper Cutter Assy

Start Date: 7/22/2016

Required Date: 8/18/2016

Start Qty: 5.00

Required Qty: 5.00

646.3314 Manufactured No

110 Each 3.0000 1 5

646 3314

Blade

Location

Loc Qty

Loc Code

cck103

3

142644

3

3

DAS 149314
36
9-89 ~~148327~~ (2x)

646.3315 Manufactured No

110 Each 5.0000 1 5

646 3315

Blade

Location

Loc Qty

Loc Code

cck103

5

142476

5

5

DAS 6
9-89

646.3316 Manufactured No

110 Each 6.0000 1 5

646 3316

Blade

Location

Loc Qty

Loc Code

cck103

6

142636

6

5

DAS 6
9-89

NAS1149FN832P Purchased No

110 Each 2,531.000 36 180

NAS1149FN832P

Washer

Location

Loc Qty

Loc Code

GA

181

M133316

16

M133769

165

ST260a

1600

M135058

1600

ST263

750

M134257

750

180

DAS 36
9-89

JUL 27 2016 DAS 6
9-89

Friday, July 22, 2016 10:37:42 AM

Shop Packet Print

Page 2

DQA: _____ Date: _____



WORK ORDER NON-CONFORMANCE / UPDATE

QA Closed: _____ Date: _____

Work Order update only ☐

Work Order: _____ Part No. _____ NCR No. _____		DISPOSITION Rework ☐ Scrap ☐ Use-as-is ☐ Suspected Unapproved ☐		AGAINST DEPARTMENT/PROCESS Skid-tube ☐ Machining ☐ Thermoforming ☐ Large Fab ☐ Cross tube ☐ Small Fab ☐ Finishing ☐ Composite ☐ Water Jet ☐ Prod. Eng. Coord. ☐ Rec/Store/Packaging ☐ Supplier ☐ Engineering ☐ Quality ☐ Other ☐					
Date :		Step #:		QTY Effective :			MRB (QSI042) Approval		
Description Work Order Deviation				Disposition				Completed By	
								Lead hand / Supervisor Approval Verification	
Root Cause		FAULT CATEGORY							
Environment ☐	No Re-verification ☐	Pressure/Forced ☐	Temperature/Cure ☐	Power Loss/Surge ☐	Positioned Wrong ☐				
Design ☐	Operator ☐	Bending ☐	Set-up ☐	Folio/Program ☐	Outside Dimensions ☐				
Doc/Data ☐	Offset/Setup ☐	Centre Not Concentric ☐	BOM/Route ☐	Grain ☐	Over/Under tolerance ☐				
Equip/Tooling ☐	Supplier ☐	Cracks ☐	Broken/Damage/Defect ☐	Weld ☐	Part Incorrect ☐				
Handling/Pre ☐	Training ☐	Crimp/Kink/Ripple/Wave ☐	Inspection Incomplete/Unqualified ☐	Wrong Stock Pulled ☐	Part Lost/Missing ☐				
Material ☐	Use for Testing ☐	Cuffs ☐	Contamination ☐	Out of Sequence ☐	Part Moved ☐				
Internal Transport ☐	Poor Information ☐	Crushing ☐	Countersink ☐	Off-set ☐	Drawing ☐				
Tribal Knowledge ☐	Rushing ☐	Heat Treat ☐	Cut Too Short ☐	Mislabeled ☐	Finish ☐				
LOA ☐	Product Improvement ☐	Wave/Twist in Tube ☐	Instructions Incomplete/Unclear ☐	Fit/Function ☐	Misread ☐				
Substation ☐	Process Improvement ☐	Marks/Chatter ☐	Drill Holes ☐	Misaligned/off center ☐	Turning Sequence ☐				
Past Expiry Date ☐	Manufacturing Process ☐	OTHER : _____							
Misidentified ☐	Past Due ☐								

Picklist Print

Friday, July 22, 2016 10:37:43 AM

Page 3

Work Order ID: 149304

149304

Parent Item: 646.3301

646.3301

Parent Item Name: Upper Cutter Assy

Start Date: 7/22/2016

Required Date: 8/18/2016

Start Qty: 5.00

Required Qty: 5.00

MS21042L08

Purchased

No

110

Each

916.0000

18

90

MS21042L08

Nut

DAS
6
9-89

Location

Loc Qty

Loc Code

GA

169

m134063

169

ST303

733

m133922

37

m134962

146

m135046

350

m135133

100

m135274

100

ST308

14

m134376

14

90

DAS
18 36
9-89

NAS1149F0332P

Purchased

No

110

Each

2,579.000

6

30

NAS1149F0332P

Washer

DAS
6
9-89

Location

Loc Qty

Loc Code

GA

282

m133709

282

ST262

2297

m134257

37

m134676

260

m135058

2000

DAS
36
9-89

30

AN3-12A

Purchased

No

110

Each

49.0000

2

10

AN3-12A

Bolt

DAS
6
9-89

Location

Loc Qty

Loc Code

ST349

49

m133064

16

m134257

33

2 DAS
10 36
9-89

JUL 27 2016

Friday, July 22, 2016 10:37:43 AM

Shop Packet Print

Page 3

DQA: _____ Date: _____



WORK ORDER NON-CONFORMANCE / UPDATE

QA Closed: _____ Date: _____

Work Order update only ☐

Work Order: _____ Part No. _____ NCR No. _____		DISPOSITION Rework ☐ Scrap ☐ Use-as-is ☐ Suspected Unapproved ☐		AGAINST DEPARTMENT/PROCESS Skid-tube ☐ Machining ☐ Thermoforming ☐ Large Fab ☐ Cross tube ☐ Small Fab ☐ Finishing ☐ Composite ☐ Water Jet ☐ Prod. Eng. Coord. ☐ Rec/Store/Packaging ☐ Supplier ☐ Engineering ☐ Quality ☐ Other ☐					
Date :		Step #:		QTY Effective :			MRB (QSI042) Approval		
Description Work Order Deviation				Disposition				Completed By Lead hand / Supervisor Approval Verification QC / QA Coordinator Approval	
Root Cause		FAULT CATEGORY							
Environment ☐	No Re-verification ☐	Pressure/Forced ☐	Temperature/Cure ☐	Power Loss/Surge ☐	Positioned Wrong ☐				
Design ☐	Operator ☐	Bending ☐	Set-up ☐	Folio/Program ☐	Outside Dimensions ☐				
Doc/Data ☐	Offset/Setup ☐	Centre Not Concentric ☐	BOM/Route ☐	Grain ☐	Over/Under tolerance ☐				
Equip/Tooling ☐	Supplier ☐	Cracks ☐	Broken/Damage/Defect ☐	Weld ☐	Part Incorrect ☐				
Handling/Pre ☐	Training ☐	Crimp/Kink/Ripple/Wave ☐	Inspection Incomplete/Unqualified ☐	Wrong Stock Pulled ☐	Part Lost/Missing ☐				
Material ☐	Use for Testing ☐	Cuffs ☐	Contamination ☐	Out of Sequence ☐	Part Moved ☐				
Internal Transport ☐	Poor Information ☐	Crushing ☐	Countersink ☐	Off-set ☐	Drawing ☐				
Tribal Knowledge ☐	Rushing ☐	Heat Treat ☐	Cut Too Short ☐	Mislabeled ☐	Finish ☐				
LOA ☐	Product Improvement ☐	Wave/Twist in Tube ☐	Instructions Incomplete/Unclear ☐	Fit/Function ☐	Misread ☐				
Substation ☐	Process Improvement ☐	Marks/Chatter ☐	Drill Holes ☐	Misaligned/off center ☐	Turning Sequence ☐				
Past Expiry Date ☐	Manufacturing Process ☐								
Misidentified ☐	Past Due ☐	OTHER :							

Picklist Print

Friday, July 22, 2016 10:37:43 AM

Page 4

Work Order ID: 149304

149304

Parent Item: 646.3301

646.3301

Parent Item Name: Upper Cutter Assy

Start Date: 7/22/2016

Required Date: 8/18/2016

Start Qty: 5.00

Required Qty: 5.00

MS21042L3

Purchased

No

110

Each

2,313.000

3

15

MS21042L3

Nut

DAS
6
9-89

Location

Loc Qty

Loc Code

CCK007

600

m135056

600

FP001

14

m133790

14

GA

571

m134360

112

m135135

459

OVER007

700

m135135

700

ST303

428

m134039

12

m134943

416

DAS
36
9-89

3

15

MS27039-08-19

Purchased

No

110

Each

366.0000

18

90

MS27039-08-19

Screw

DAS
6
9-89

Location

Loc Qty

Loc Code

GA

270

m132930

84

m133077

22

m134063

64

m135046

100

ST277

96

m135133

96

90

JUL 27 2016

M135948

DAS
36
9-89

18x

Friday, July 22, 2016 10:37:43 AM

Shop Packet Print

Page 4

DQA: _____ Date: _____

WORK ORDER NON-CONFORMANCE / UPDATE



QA Closed: _____ Date: _____

Work Order update only ☐

Work Order: _____ Part No. _____ NCR No. _____		DISPOSITION Rework ☐ Scrap ☐ Use-as-is ☐ Suspected Unapproved ☐		AGAINST DEPARTMENT/PROCESS Skid-tube ☐ Machining ☐ Thermoforming ☐ Large Fab ☐ Cross tube ☐ Small Fab ☐ Finishing ☐ Composite ☐ Water Jet ☐ Prod. Eng. Coord. ☐ Rec/Store/Packaging ☐ Supplier ☐ Engineering ☐ Quality ☐ Other ☐					
Date :		Step #:		QTY Effective :			MRB (QSI042) Approval 		
Description Work Order Deviation				Disposition					
								Completed By	
								Lead hand / Supervisor Approval Verification	
								QC / QA Coordinator Approval	

Root Cause				FAULT CATEGORY			
Environment ☐		No Re-verification ☐		Pressure/Forced ☐		Temperature/Cure ☐	
Design ☐		Operator ☐		Bending ☐		Set-up ☐	
Doc/Data ☐		Offset/Setup ☐		Centre Not Concentric ☐		BOM/Route ☐	
Equip/Tooling ☐		Supplier ☐		Cracks ☐		Broken/Damage/Defect ☐	
Handling/Pre ☐		Training ☐		Crimp/Kink/Ripple/Wave ☐		Inspection Incomplete/Unqualified ☐	
Material ☐		Use for Testing ☐		Cuffs ☐		Contamination ☐	
Internal Transport ☐		Poor Information ☐		Crushing ☐		Countersink ☐	
Tribal Knowledge ☐		Rushing ☐		Heat Treat ☐		Cut Too Short ☐	
LOA ☐		Product Improvement ☐		Wave/Twist in Tube ☐		Instructions Incomplete/Unclear ☐	
Substation ☐		Process Improvement ☐		Marks/Chatter ☐		Drill Holes ☐	
Past Expiry Date ☐		Manufacturing Process ☐		OTHER :			
Misidentified ☐		Past Due ☐					

Friday, July 22, 2016 10:37:43 AM

149304

646 3301

Required Qty: 5.00

5

DAS

6

8-89

29

1 R

5 ~~36~~ DA
36
9-88

Jul 27 2016

DQA: _____ Date: _____



WORK ORDER NON-CONFORMANCE / UPDATE

QA Closed: _____ Date: _____

Work Order update only ☐

Work Order: _____ Part No. _____ NCR No. _____	DISPOSITION Rework ☐ Scrap ☐ Use-as-is ☐ Suspected Unapproved ☐	AGAINST DEPARTMENT/PROCESS <table style="width:100%; border: none;"> <tr> <td style="border: none;">Skid-tube ☐</td> <td style="border: none;">Cross tube ☐</td> <td style="border: none;">Water Jet ☐</td> <td style="border: none;">Engineering ☐</td> </tr> <tr> <td style="border: none;">Machining ☐</td> <td style="border: none;">Small Fab ☐</td> <td style="border: none;">Prod. Eng. Coord. ☐</td> <td style="border: none;">Quality ☐</td> </tr> <tr> <td style="border: none;">Thermoforming ☐</td> <td style="border: none;">Finishing ☐</td> <td style="border: none;">Rec/Store/Packaging ☐</td> <td style="border: none;">Other ☐</td> </tr> <tr> <td style="border: none;">Large Fab ☐</td> <td style="border: none;">Composite ☐</td> <td style="border: none;">Supplier ☐</td> <td></td> </tr> </table>				Skid-tube ☐	Cross tube ☐	Water Jet ☐	Engineering ☐	Machining ☐	Small Fab ☐	Prod. Eng. Coord. ☐	Quality ☐	Thermoforming ☐	Finishing ☐	Rec/Store/Packaging ☐	Other ☐	Large Fab ☐	Composite ☐	Supplier ☐	
Skid-tube ☐	Cross tube ☐	Water Jet ☐	Engineering ☐	
Machining ☐	Small Fab ☐	Prod. Eng. Coord. ☐	Quality ☐	
Thermoforming ☐	Finishing ☐	Rec/Store/Packaging ☐	Other ☐	
Large Fab ☐	Composite ☐	Supplier ☐	
Date : _____	Step #: _____	QTY Effective : _____		MRB (QSI042) Approval	
Description Work Order Deviation		Disposition			Completed By	
					Lead hand / Supervisor Approval Verification	
					QC / QA Coordinator Approval	
Root Cause <table style="width:100%; border: none;"> <tr> <td style="border: none;">Environment ☐</td> <td style="border: none;">No Re-verification ☐</td> </tr> <tr> <td style="border: none;">Design ☐</td> <td style="border: none;">Operator ☐</td> </tr> <tr> <td style="border: none;">Doc/Data ☐</td> <td style="border: none;">Offset/Setup ☐</td> </tr> <tr> <td style="border: none;">Equip/Tooling ☐</td> <td style="border: none;">Supplier ☐</td> </tr> <tr> <td style="border: none;">Handling/Pre ☐</td> <td style="border: none;">Training ☐</td> </tr> <tr> <td style="border: none;">Material ☐</td> <td style="border: none;">Use for Testing ☐</td> </tr> <tr> <td style="border: none;">Internal Transport ☐</td> <td style="border: none;">Poor Information ☐</td> </tr> <tr> <td style="border: none;">Tribal Knowledge ☐</td> <td style="border: none;">Rushing ☐</td> </tr> <tr> <td style="border: none;">LOA ☐</td> <td style="border: none;">Product Improvement ☐</td> </tr> <tr> <td style="border: none;">Substation ☐</td> <td style="border: none;">Process Improvement ☐</td> </tr> <tr> <td style="border: none;">Past Expiry Date ☐</td> <td style="border: none;">Manufacturing Process ☐</td> </tr> <tr> <td style="border: none;">Misidentified ☐</td> <td style="border: none;">Past Due ☐</td> </tr> </table>		Environment ☐	No Re-verification ☐	Design ☐	Operator ☐	Doc/Data ☐	Offset/Setup ☐	Equip/Tooling ☐	Supplier ☐	Handling/Pre ☐	Training ☐	Material ☐	Use for Testing ☐	Internal Transport ☐	Poor Information ☐	Tribal Knowledge ☐	Rushing ☐	LOA ☐	Product Improvement ☐	Substation ☐	Process Improvement ☐	Past Expiry Date ☐	Manufacturing Process ☐	Misidentified ☐	Past Due ☐	FAULT CATEGORY <table style="width:100%; border: none;"> <tr> <td style="border: none;">Pressure/Forced ☐</td> <td style="border: none;">Temperature/Cure ☐</td> <td style="border: none;">Power Loss/Surge ☐</td> <td style="border: none;">Positioned Wrong ☐</td> </tr> <tr> <td style="border: none;">Bending ☐</td> <td style="border: none;">Set-up ☐</td> <td style="border: none;">Folio/Program ☐</td> <td style="border: none;">Outside Dimensions ☐</td> </tr> <tr> <td style="border: none;">Centre Not Concentric ☐</td> <td style="border: none;">BOM/Route ☐</td> <td style="border: none;">Grain ☐</td> <td style="border: none;">Over/Under tolerance ☐</td> </tr> <tr> <td style="border: none;">Cracks ☐</td> <td style="border: none;">Broken/Damage/Defect ☐</td> <td style="border: none;">Weld ☐</td> <td style="border: none;">Part Incorrect ☐</td> </tr> <tr> <td style="border: none;">Crimp/Kink/Ripple/Wave ☐</td> <td style="border: none;">Inspection Incomplete/Unqualified ☐</td> <td style="border: none;">Wrong Stock Pulled ☐</td> <td style="border: none;">Part Lost/Missing ☐</td> </tr> <tr> <td style="border: none;">Cuffs ☐</td> <td style="border: none;">Contamination ☐</td> <td style="border: none;">Out of Sequence ☐</td> <td style="border: none;">Part Moved ☐</td> </tr> <tr> <td style="border: none;">Crushing ☐</td> <td style="border: none;">Countersink ☐</td> <td style="border: none;">Off-set ☐</td> <td style="border: none;">Drawing ☐</td> </tr> <tr> <td style="border: none;">Heat Treat ☐</td> <td style="border: none;">Cut Too Short ☐</td> <td style="border: none;">Mislabeled ☐</td> <td style="border: none;">Finish ☐</td> </tr> <tr> <td style="border: none;">Wave/Twist in Tube ☐</td> <td style="border: none;">Instructions Incomplete/Unclear ☐</td> <td style="border: none;">Fit/Function ☐</td> <td style="border: none;">Misread ☐</td> </tr> <tr> <td style="border: none;">Marks/Chatter ☐</td> <td style="border: none;">Drill Holes ☐</td> <td style="border: none;">Misaligned/off center ☐</td> <td style="border: none;">Turning Sequence ☐</td> </tr>
OTHER : _____	

APICAL

INDUSTRIES, INC.

ENGINEERING CHANGE NOTICE NO.

04765

SHEET 1 OF 1

DWG NO. 646.3300

REV: NC

PREPARED BY J. SOTO

DATE: 12/08/2014

EFFECT ON DWG
☐ INC. ☒ UNINC.

DWG TITLE: UPPER CUTTER ASSY

APPROVED BY:

ENGR. *[Signature]*

MFG

[Signature]

QC


[Signature]

EFF. NEXT ORDER

TRANSACTION CODES (TC):
A-ADD C-CREATE
R-REVISE D-DELETE

REASON: ADDED HOLE DIMENSION TO 646.3313.

SHEET 5 IS:

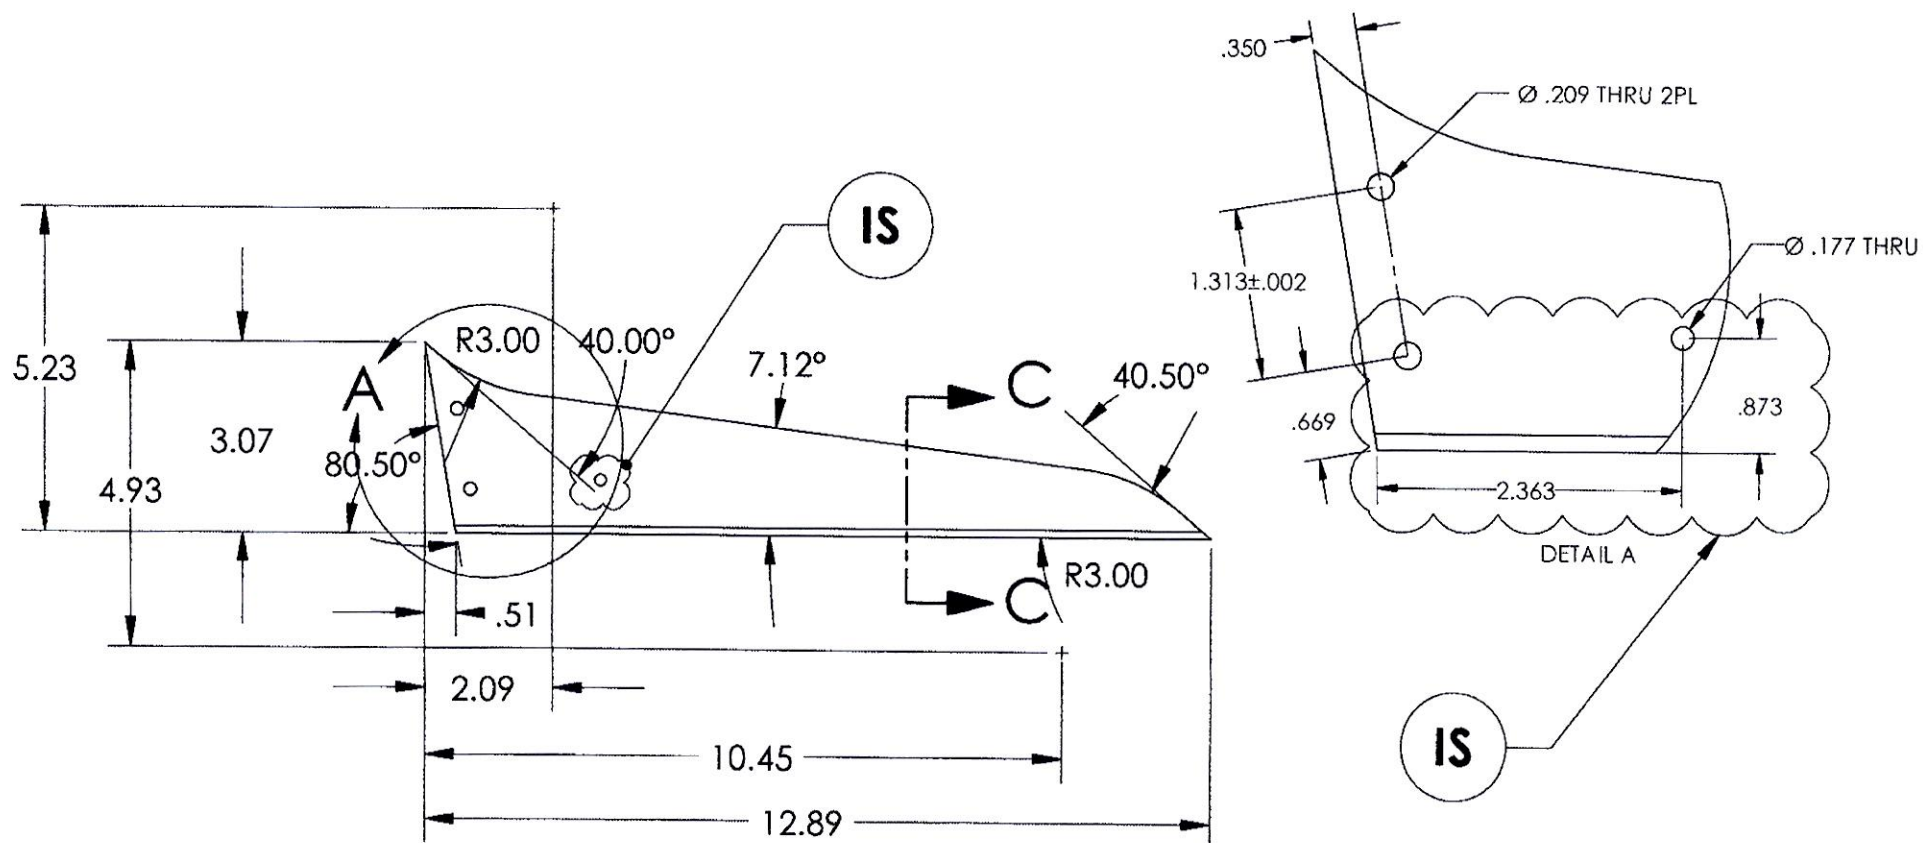

DOCUMENTS EFFECTED:

☐ MDL ☐ INSTALL INSTRUCTIONS ☐ ICA ☐ FMS ☐ BOM

CHANGE CATEGORY

☐ MAJOR ☒ MINOR


DER REVIEW REQUIRED

☐ YES ☒ NO

w/o 149304

sm 16/07/22.

APICAL INDUSTRIES, INC.	ENGINEERING CHANGE NOTICE NO. 03724				SHEET 1 OF 1	
	DWG NO. 646.3300	REV: N/C	PREPARED BY B. PETERS	DATE: 12/05/12	EFFECT ON DWG ☐ INC. ☒ UNINC.	
	DWG TITLE: UPPER CUTTER ASSY					
	APPROVED BY: ENGR <i>[Signature]</i>	MFG <i>[Signature]</i>	QC <i>[Signature]</i>	EFF: NEXT ORDER		
TRANSACTION CODES (TC) A-ADD C-CREATE R-REVISE D-DELETE	REASON: REVISED ORDINATE DIMENSION.				ECR: D-12-025	

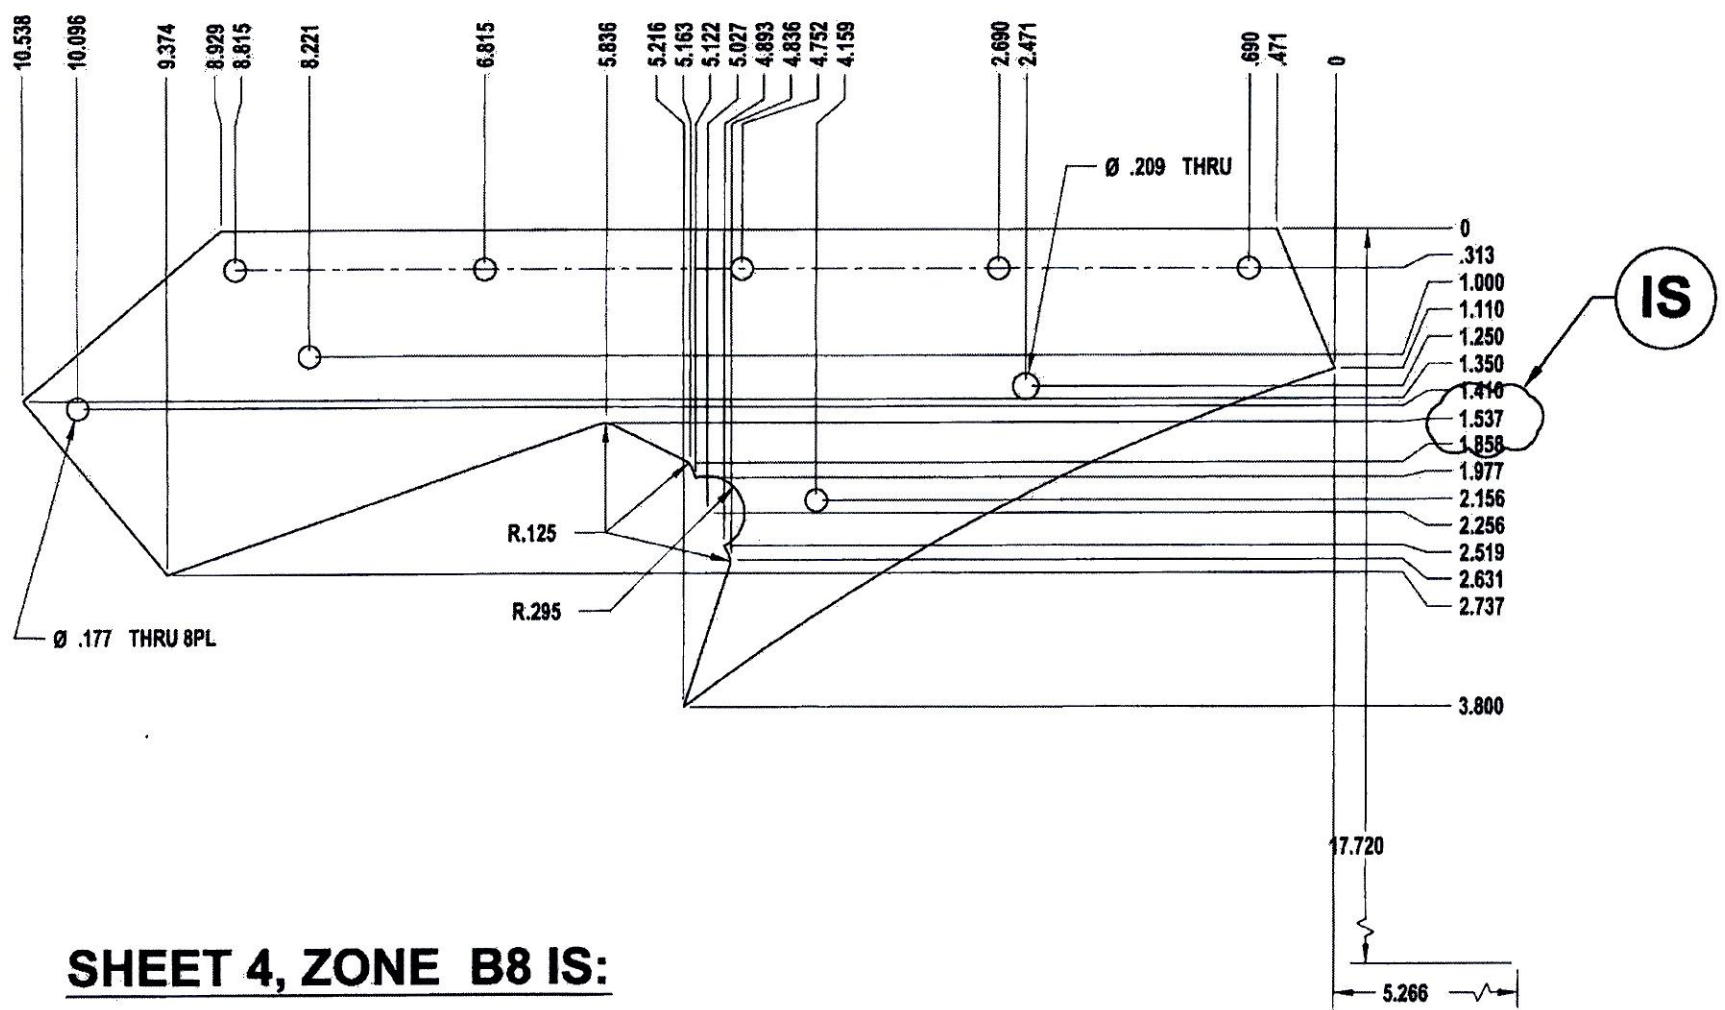


SHEET 4, ZONE B8 IS:

DOCUMENTS EFFECTED:	☐ RFMS ☐ MDL ☐ INSTALL INSTRU ☐ ICA ☐ BOM	CHANGE CATEGORY ☐ MAJOR ☒ MINOR	DER REVIEW REQUIRED ☐ YES ☒ NO
---------------------	--	---	--


APICAL INDUSTRIES, INC.	ENGINEERING CHANGE NOTICE NO.		02196		SHEET 1 OF 2	
	DWG NO.	646.3300	REV: N/C	PREPARED BY	S. HUFF	DATE: 01/05/09
	EFFECT ON DWG ☐ INC. ☒ UNINC.					
	DWG TITLE: UPPER CUTTER ASSY					
APPROVED BY:		ENGR <i>[Signature]</i>	MFG <i>[Signature]</i>	QC <i>[Signature]</i>	EFF:	NEXT ORDER
TRANSACTION CODES (TC) A-ADD C-CREATE R-REVISE D-DELETE		REASON: REMOVED RIVETS IN FAVOR OF ADDITIONAL SCREWS				

SHEET 1, VIEW 646.3301, IS:

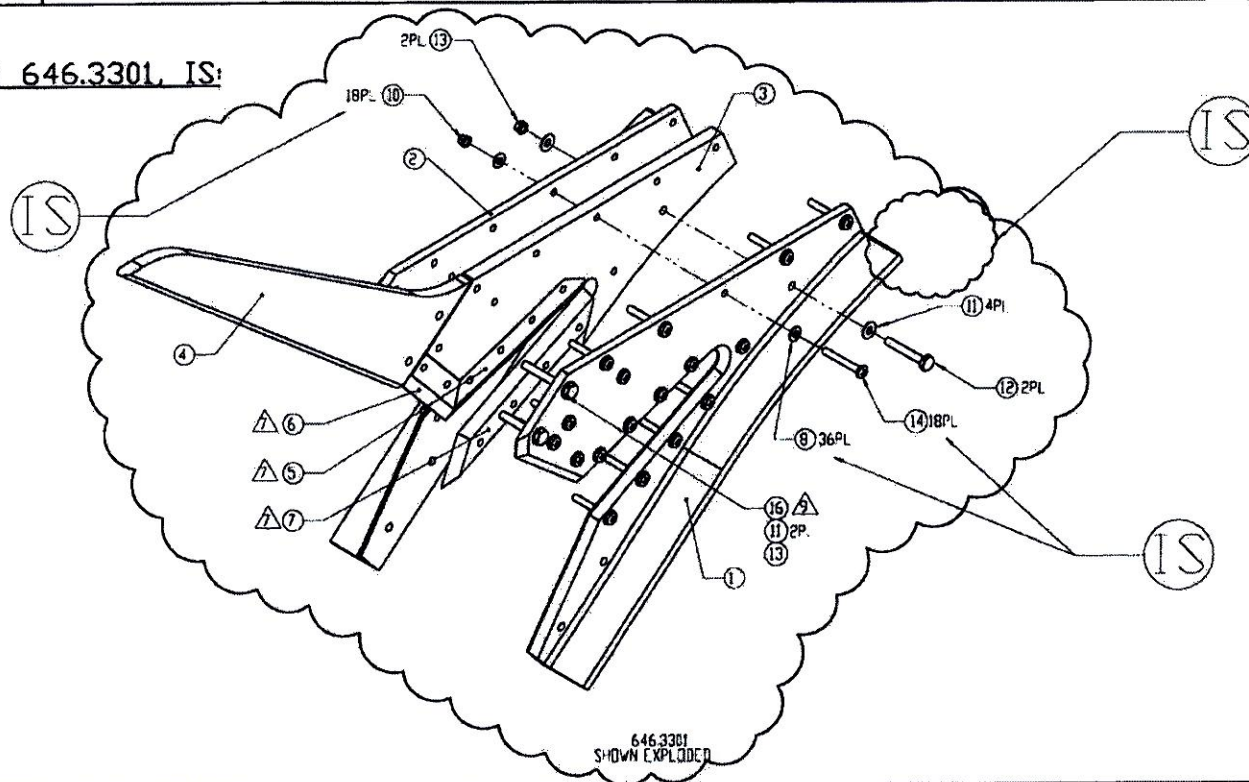

14	R	601.2765		18	SCREW	MS27039-0819
10	R	601.1541		18	LOCKNUT	MS21042L08
9	D	601.2766		3	RIVET	MS20470AD5-18
8	R	601.2764		36	WASHER	NAS1149FN832P
				.3301		
F/N TC	PART NUMBER	QTY	DESCRIPTION	MATERIAL/SPECIFICATION		
DOCUMENTS EFFECTED:				CHANGE CATEGORY		DER REVIEW REQUIRED
				☐ MDL ☒ INSTALL INSTRU ☒ ICA ☐ FMS ☒ BOM		☐ YES ☒ NO
				☐ MAJOR ☒ MINOR		

SHEET 3. SECTION VIEW A-A, IS:

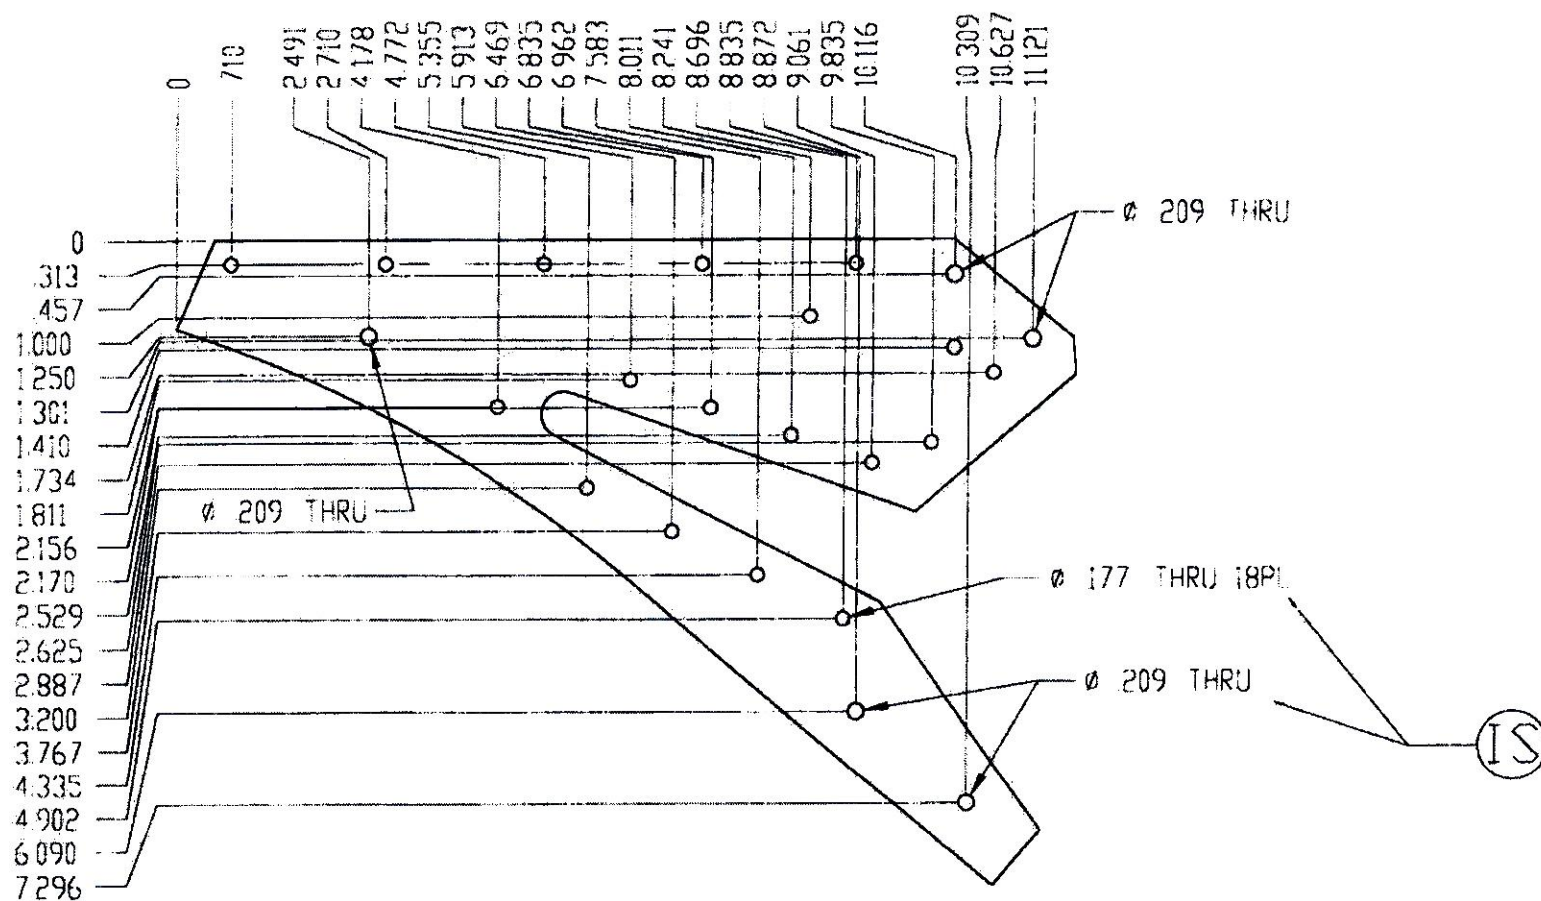

SECTION A-A

F/N	TC	PART NUMBER	QTY	DESCRIPTION	MATERIAL/SPECIFICATION

1 MATERIAL: ALUMINUM 7075-T651 PER AMS-QQ-A-250/12

△2 FINISH: HARD ANODIZE IAW MIL-A-8625 TYPE III,
CLASS 2, COLOR BLACK;
CARDINAL 4860-50 PRETREATMENT PRIMER
PRIME IAW MIL-P-23377J TYPE I CLASS N

3 MATERIAL: AISI A2 TOOL STEEL
CONDITION: ANNEALED
POST PROCESS: HEAT TREAT TO 58-62 Rc ROCKWELL HARDNESS

4 FINISH: PRIME IAW MIL-P-23377J TYPE I CLASS N

5. DEBURR AND BREAK ALL SHARP EDGES EXCEPT WHERE OTHERWISE NOTED

6. IDENTIFY IAW MPP-120

7 APPLY F/N 15 AS REQUIRED TO ALL FAYING SURFACES OF F/N 5, 6 & 7 UPON ASSEMBLY

 CUTTING EDGE INTENDED TO BE SHARP, DO NOT BREAK SHARP EDGE

9 INSTALL FASTENER FINGER-TIGHT

646.3301
SHOWN EXPLODED

REVIEWS			
REV	DESCRIPTION	DATE	APPROVED


UNINCORPORATED ECN(S)

02196, 03724, 04765


		1	7	646.3316	BLADE		△	△
		1	6	646.3315	BLADE		△	△
		1	5	646.3314	BLADE		△	△
		1	4	646.3313	UPPER GUIDE		△	△
		1	3	646.3312	CENTER PLATE		△	△
		1	2	646.3311	RH HALF		△	△
		1	1	646.3310	LH HALF		△	△
	X			646.3301	UPPER CUTTER ASSY			
(X)	FIND #	PART #		DESCRIPTION	MATERIAL	SPEC.		

[illegible]

THE INFORMATION CONTAINED IN THIS DRAWING IS THE SOLE PROPERTY OF APICAL INDUSTRIES. ANY REPRODUCTION IN PART OR WHOLE WITHOUT THE WRITTEN PERMISSION OF APICAL INDUSTRIES IS PROHIBITED.

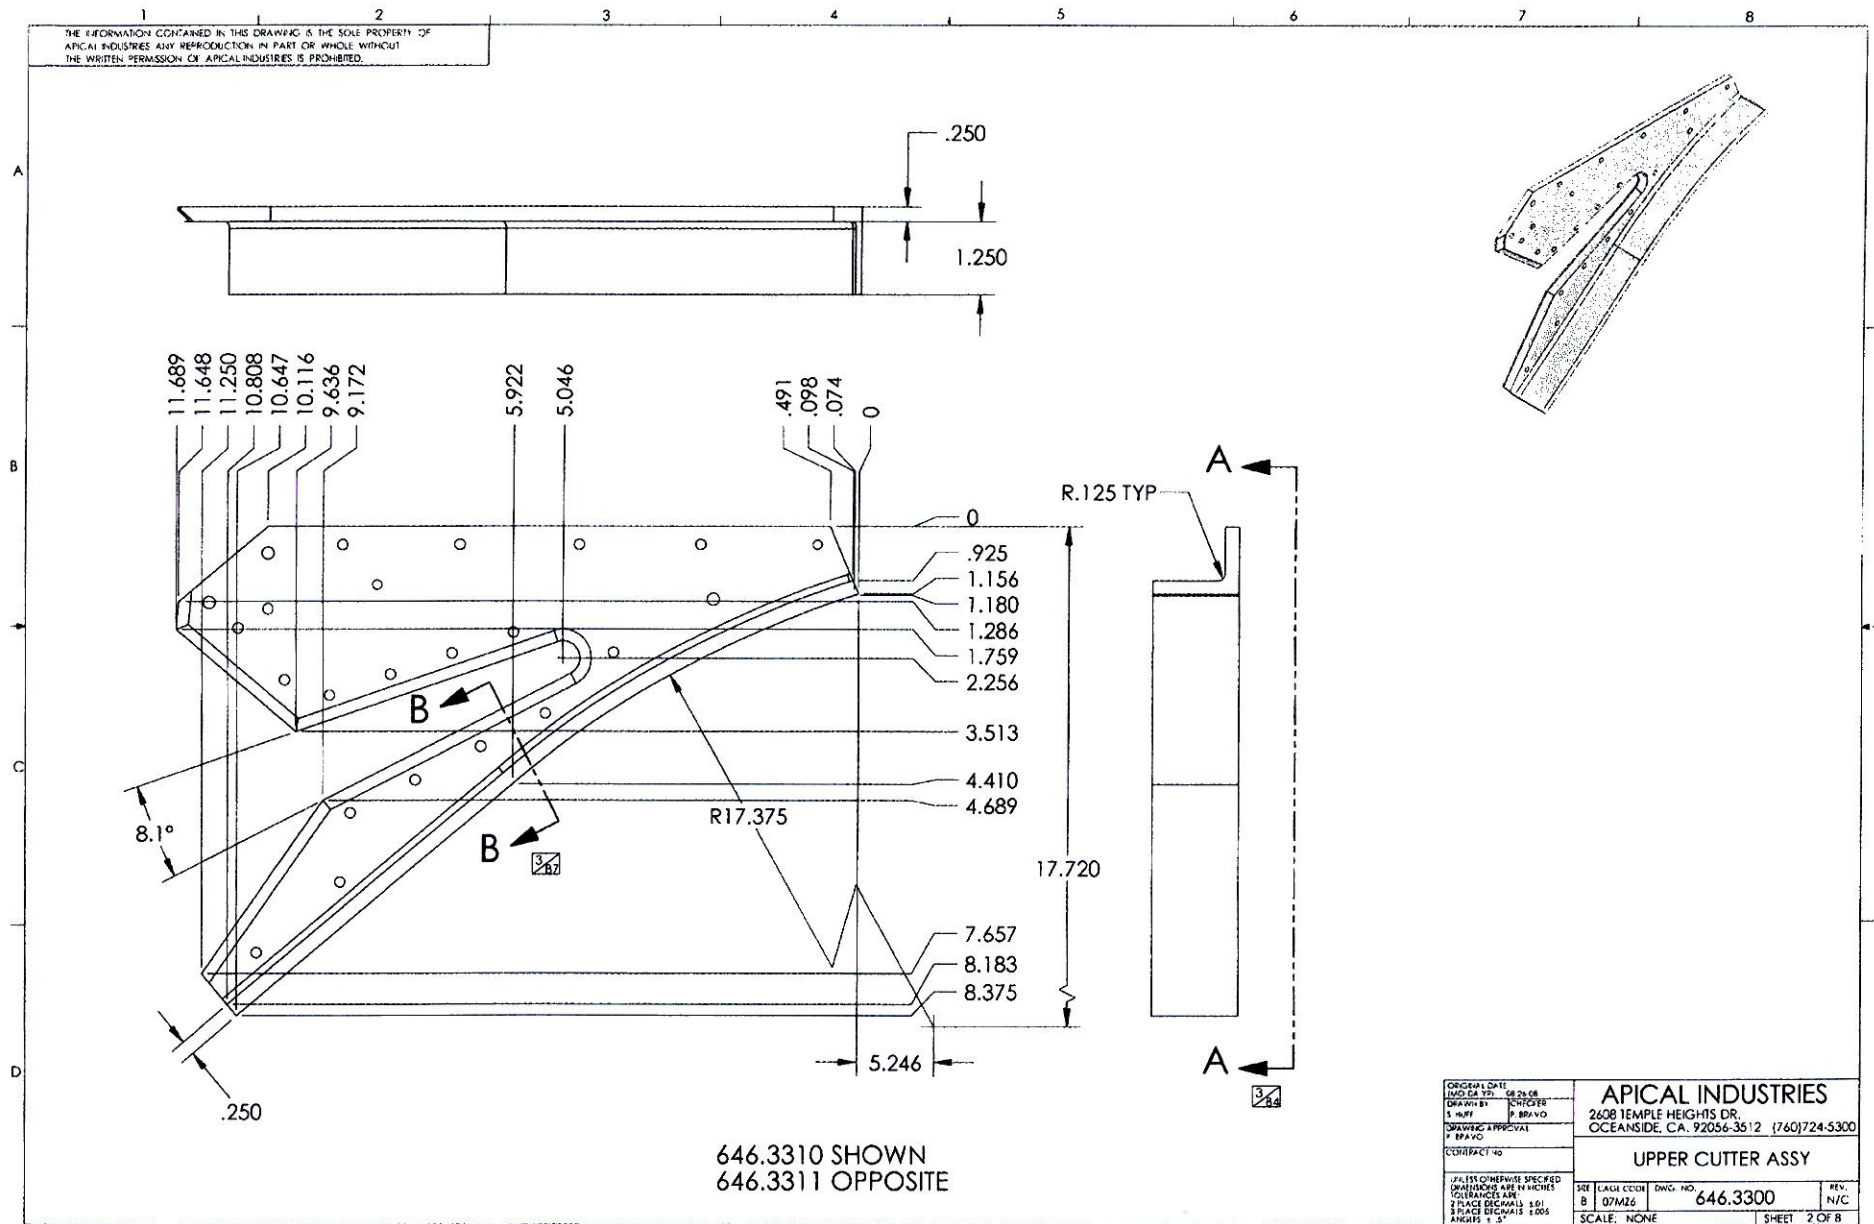


THE INFORMATION CONTAINED IN THIS DRAWING IS THE SOLE PROPERTY OF
APICAL INDUSTRIES. ANY REPRODUCTION IN PART OR WHOLE WITHOUT
THE WRITTEN PERMISSION OF APICAL INDUSTRIES IS PROHIBITED.

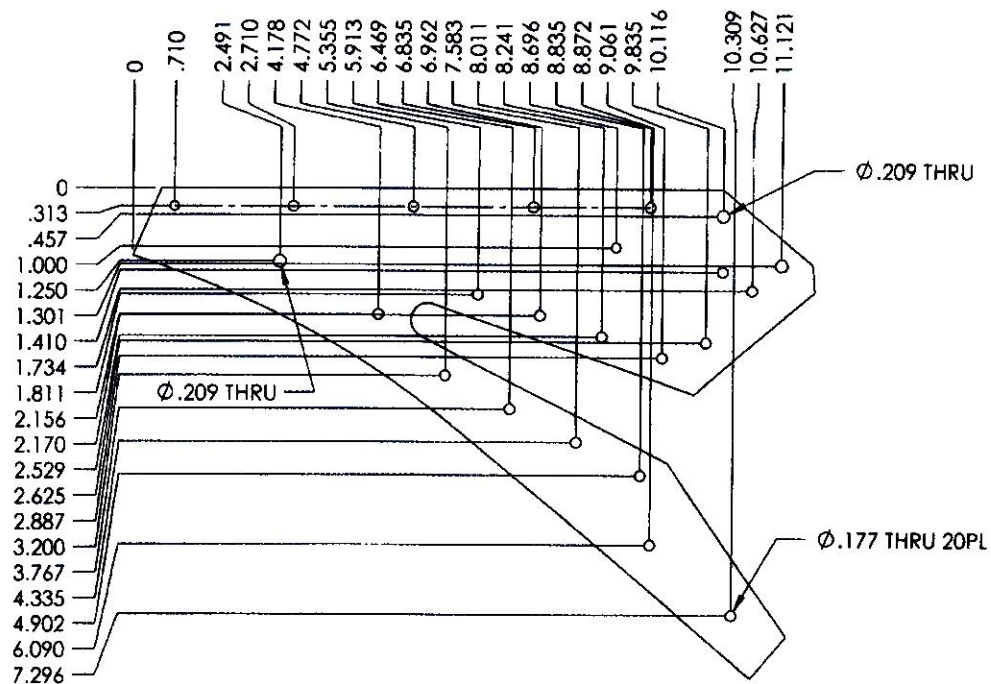

SECTION A-A

.200 X 45.0° TYP

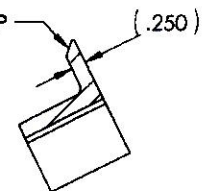

SECTION B-B

Ø .209 THRU

Ø .209 THRU


Ø .177 THRU 20PL

ORIGINAL DATE		APICAL INDUSTRIES	


REV.	DESCRIPTION	DATE	BY
1			
2			
3			
4			
5			
6			
7			
8			



646.3312
HOLE DIMENSIONS AND LOCATIONS
+/- .002

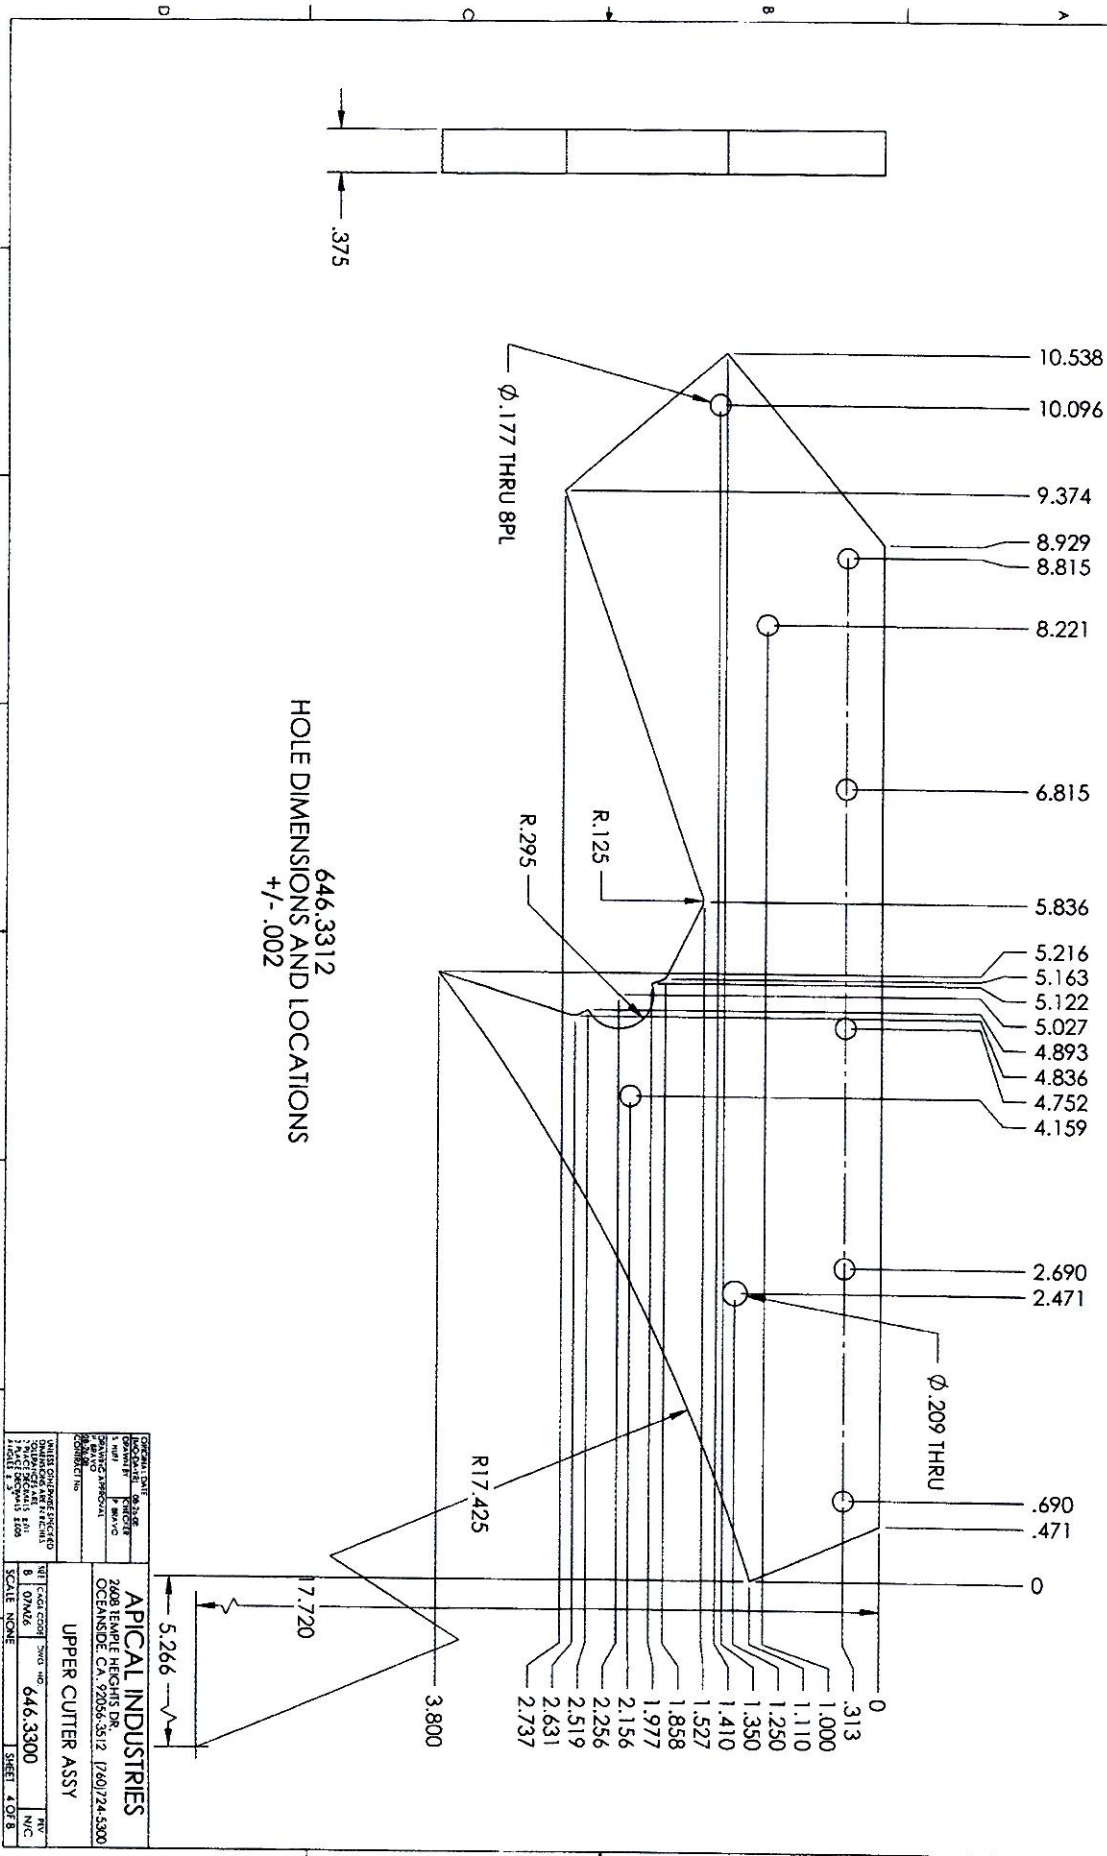



THE INFORMATION CONTAINED IN THIS DRAWING IS THE SOLE PROPERTY OF APICAL INDUSTRIES AND REPRODUCTION IN PART OR WHOLE WITHOUT THE WRITTEN PERMISSION OF APICAL INDUSTRIES IS PROHIBITED.


REVISIONS			
REV	DESCRIPTION	DATE	APPROVED

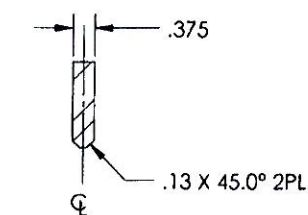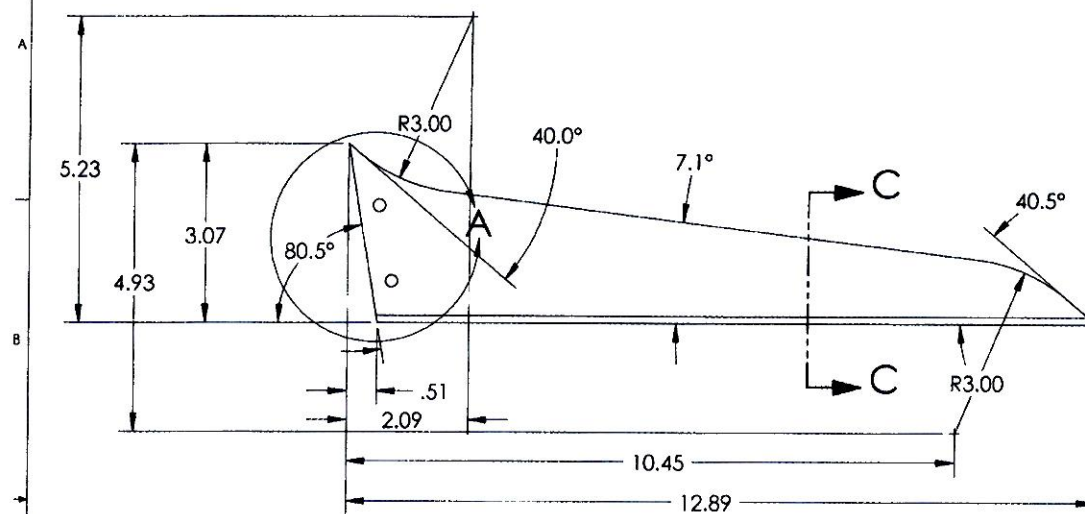

SECTION C-C

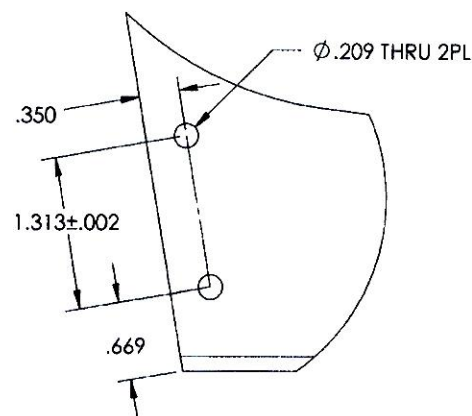

DETAIL A

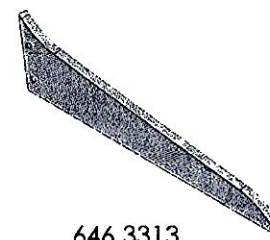

646.3313

ORIGINAL DATE: 08-26-08 DRAWN BY: C. REZIER I. HUNT TOLERANCE SPECIFIER: P. BRANCO DE-JAAR COMPARING NO.			
UNLESS OTHERWISE SPECIFIED DIMENSIONS ARE IN INCHES TOLERANCES ARE: 2 PLACE DECIMALS ±.01 3 PLACE DECIMALS ±.001 ANGLES ±.1°			
SHEET	CAGE CODE	DWG. NO.	REV.
8	07M26	646.3300	N/C
SCALE: NONE		SHEET 5 OF 8	




APICAL INDUSTRIES

2608 TEMPLE HEIGHTS DR.
OCEANSIDE, CA. 92056-3512 (760) 724-5300

UPPER CUTTER ASSY

THE INFORMATION CONTAINED IN THIS DRAWING IS THE SOLE PROPERTY OF
APICAL INDUSTRIES. ANY REPRODUCTION IN PART OR WHOLE WITHOUT
THE WRITTEN PERMISSION OF APICAL INDUSTRIES IS PROHIBITED.

REVISIONS			
REV.	DESCRIPTION	DATE	APPROVED

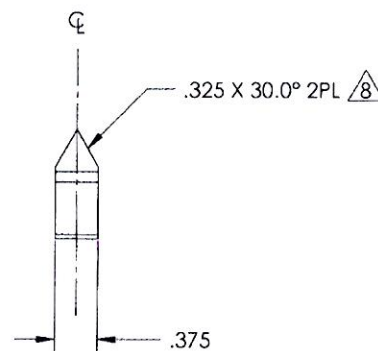
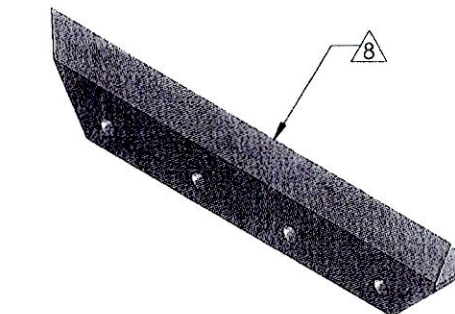
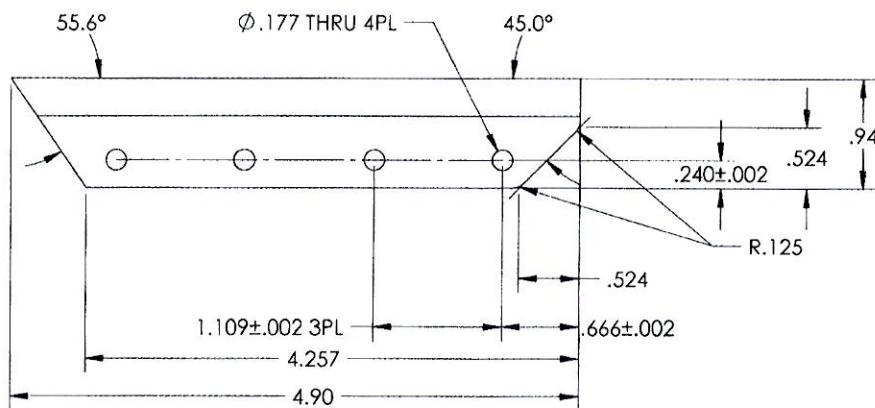


646.3314

CONTRACT NO.		646.3300	
UNLESS OTHERWISE SPECIFIED DIMENSIONS ARE IN INCHES TOLERANCES ARE: FRACTIONS DECIMALS ANGLES		REV. 8 07M26	N/C
SCALE: NONE		SHEET 6 OF 8	

THE INFORMATION CONTAINED IN THIS DRAWING IS THE SOLE PROPERTY OF APICAL INDUSTRIES. ANY REPRODUCTION IN PART OR WHOLE WITHOUT THE WRITTEN PERMISSION OF APICAL INDUSTRIES IS PROHIBITED.

REVISIONS			
REV.	DESCRIPTION	DATE	APPROVED

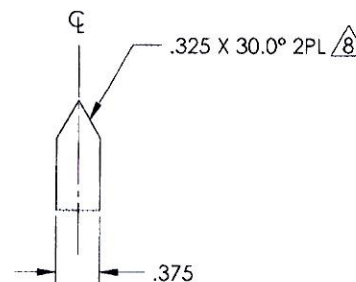
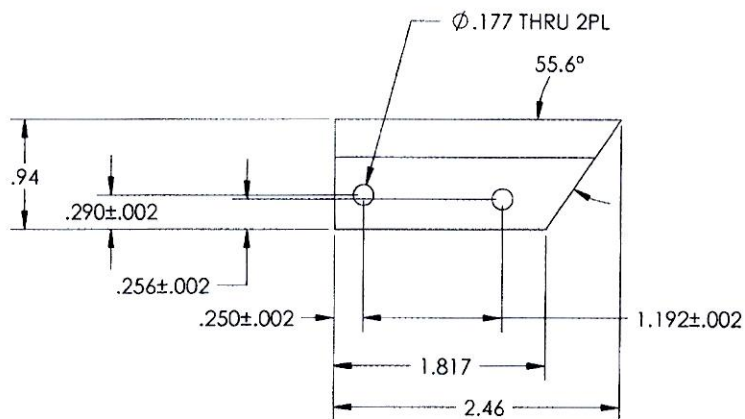
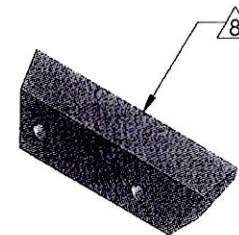


646.3315

ORIGINAL DATE 10/20/15		BY: 26-GR	
DRAWN BY S. HUFF	CHECKED P. BRAVO	APICAL INDUSTRIES 2608 TEMPLE HEIGHTS DR. OCEANSIDE, CA, 92056-3512 (760) 724-5300	
DRAWING APPROVAL P. BRAVO 08-28-16		UPPER CUTTER ASSY	
CONTRACT NO.		REV B	REV N/C
UNLESS OTHERWISE SPECIFIED: DIMENSIONS ARE IN INCHES TOLERANCES ARE: 2 PLACE DECIMALS ±.01 3 PLACE DECIMALS ±.005 ANGLES ±.5°		SCALE: NONE	SHEET 7 OF 8

THE INFORMATION CONTAINED IN THIS DRAWING IS THE SOLE PROPERTY OF APICAL INDUSTRIES. ANY REPRODUCTION IN WHOLE OR IN PART WITHOUT THE WRITTEN PERMISSION OF APICAL INDUSTRIES IS PROHIBITED.

REVISION			
REV.	DESCRIPTION	DATE	APPROVED

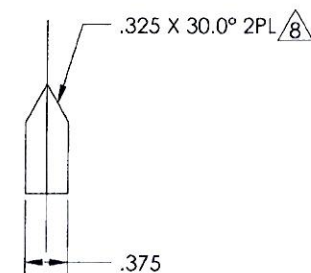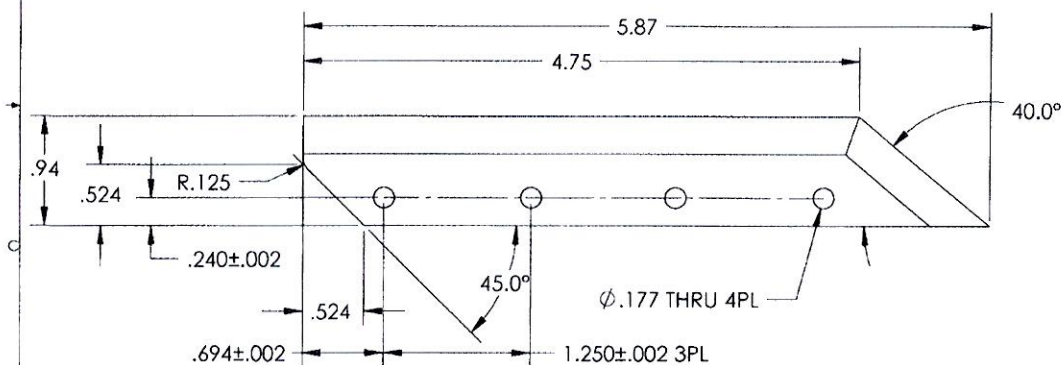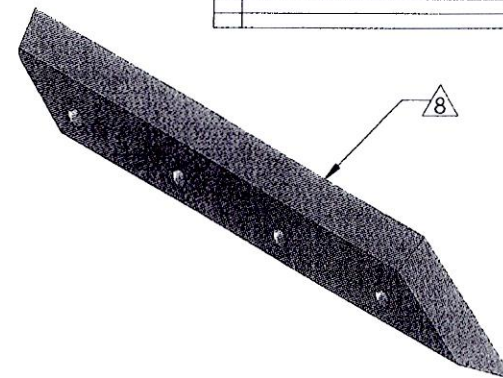

646.3316

ORIGINAL DATE: 08-26-08 DRAWN BY: C. HETZEL CHECKED BY: P. BRAVO DESIGNED APPROVAL: P. BRAVO CONTRACT NO:			
UNLESS OTHERWISE SPECIFIED DIMENSIONS ARE IN INCHES TOLERANCES ARE: 2 PLACE DECIMALS: ±.01 3 PLACE DECIMALS: ±.005 ANGLES: ±.5°			
REV.	DATE	DESCRIPTION	REV.
SCALE: NONE		SHEET 8 OF 8	

APICAL INDUSTRIES
 2608 TEMPLE HEIGHTS DR.
 OCEANSIDE, CA. 92056-3512 (760)724-5300
UPPER CUTTER ASSY

646.3300